
60 STATE STREET FLOOR PLAN

OXFORD

38th Floor – Suite 3800 – As-Built Plan - 10,607 SF

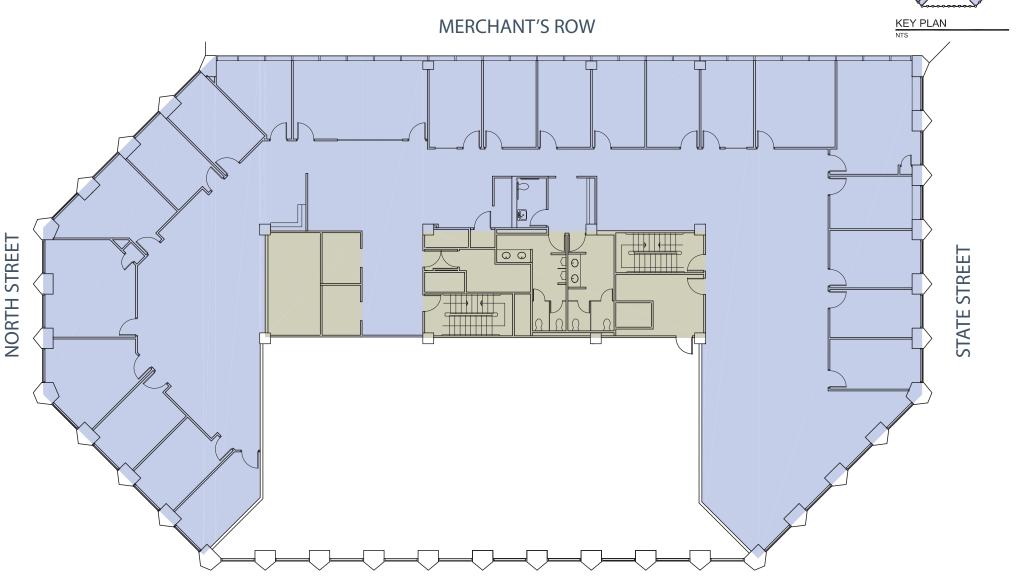

CONGRESS STREET