


# 26th Floor – Suite 2650 – 4,701 RSF

## AS BUILT PLAN

50 CALIFORNIA  
STREET

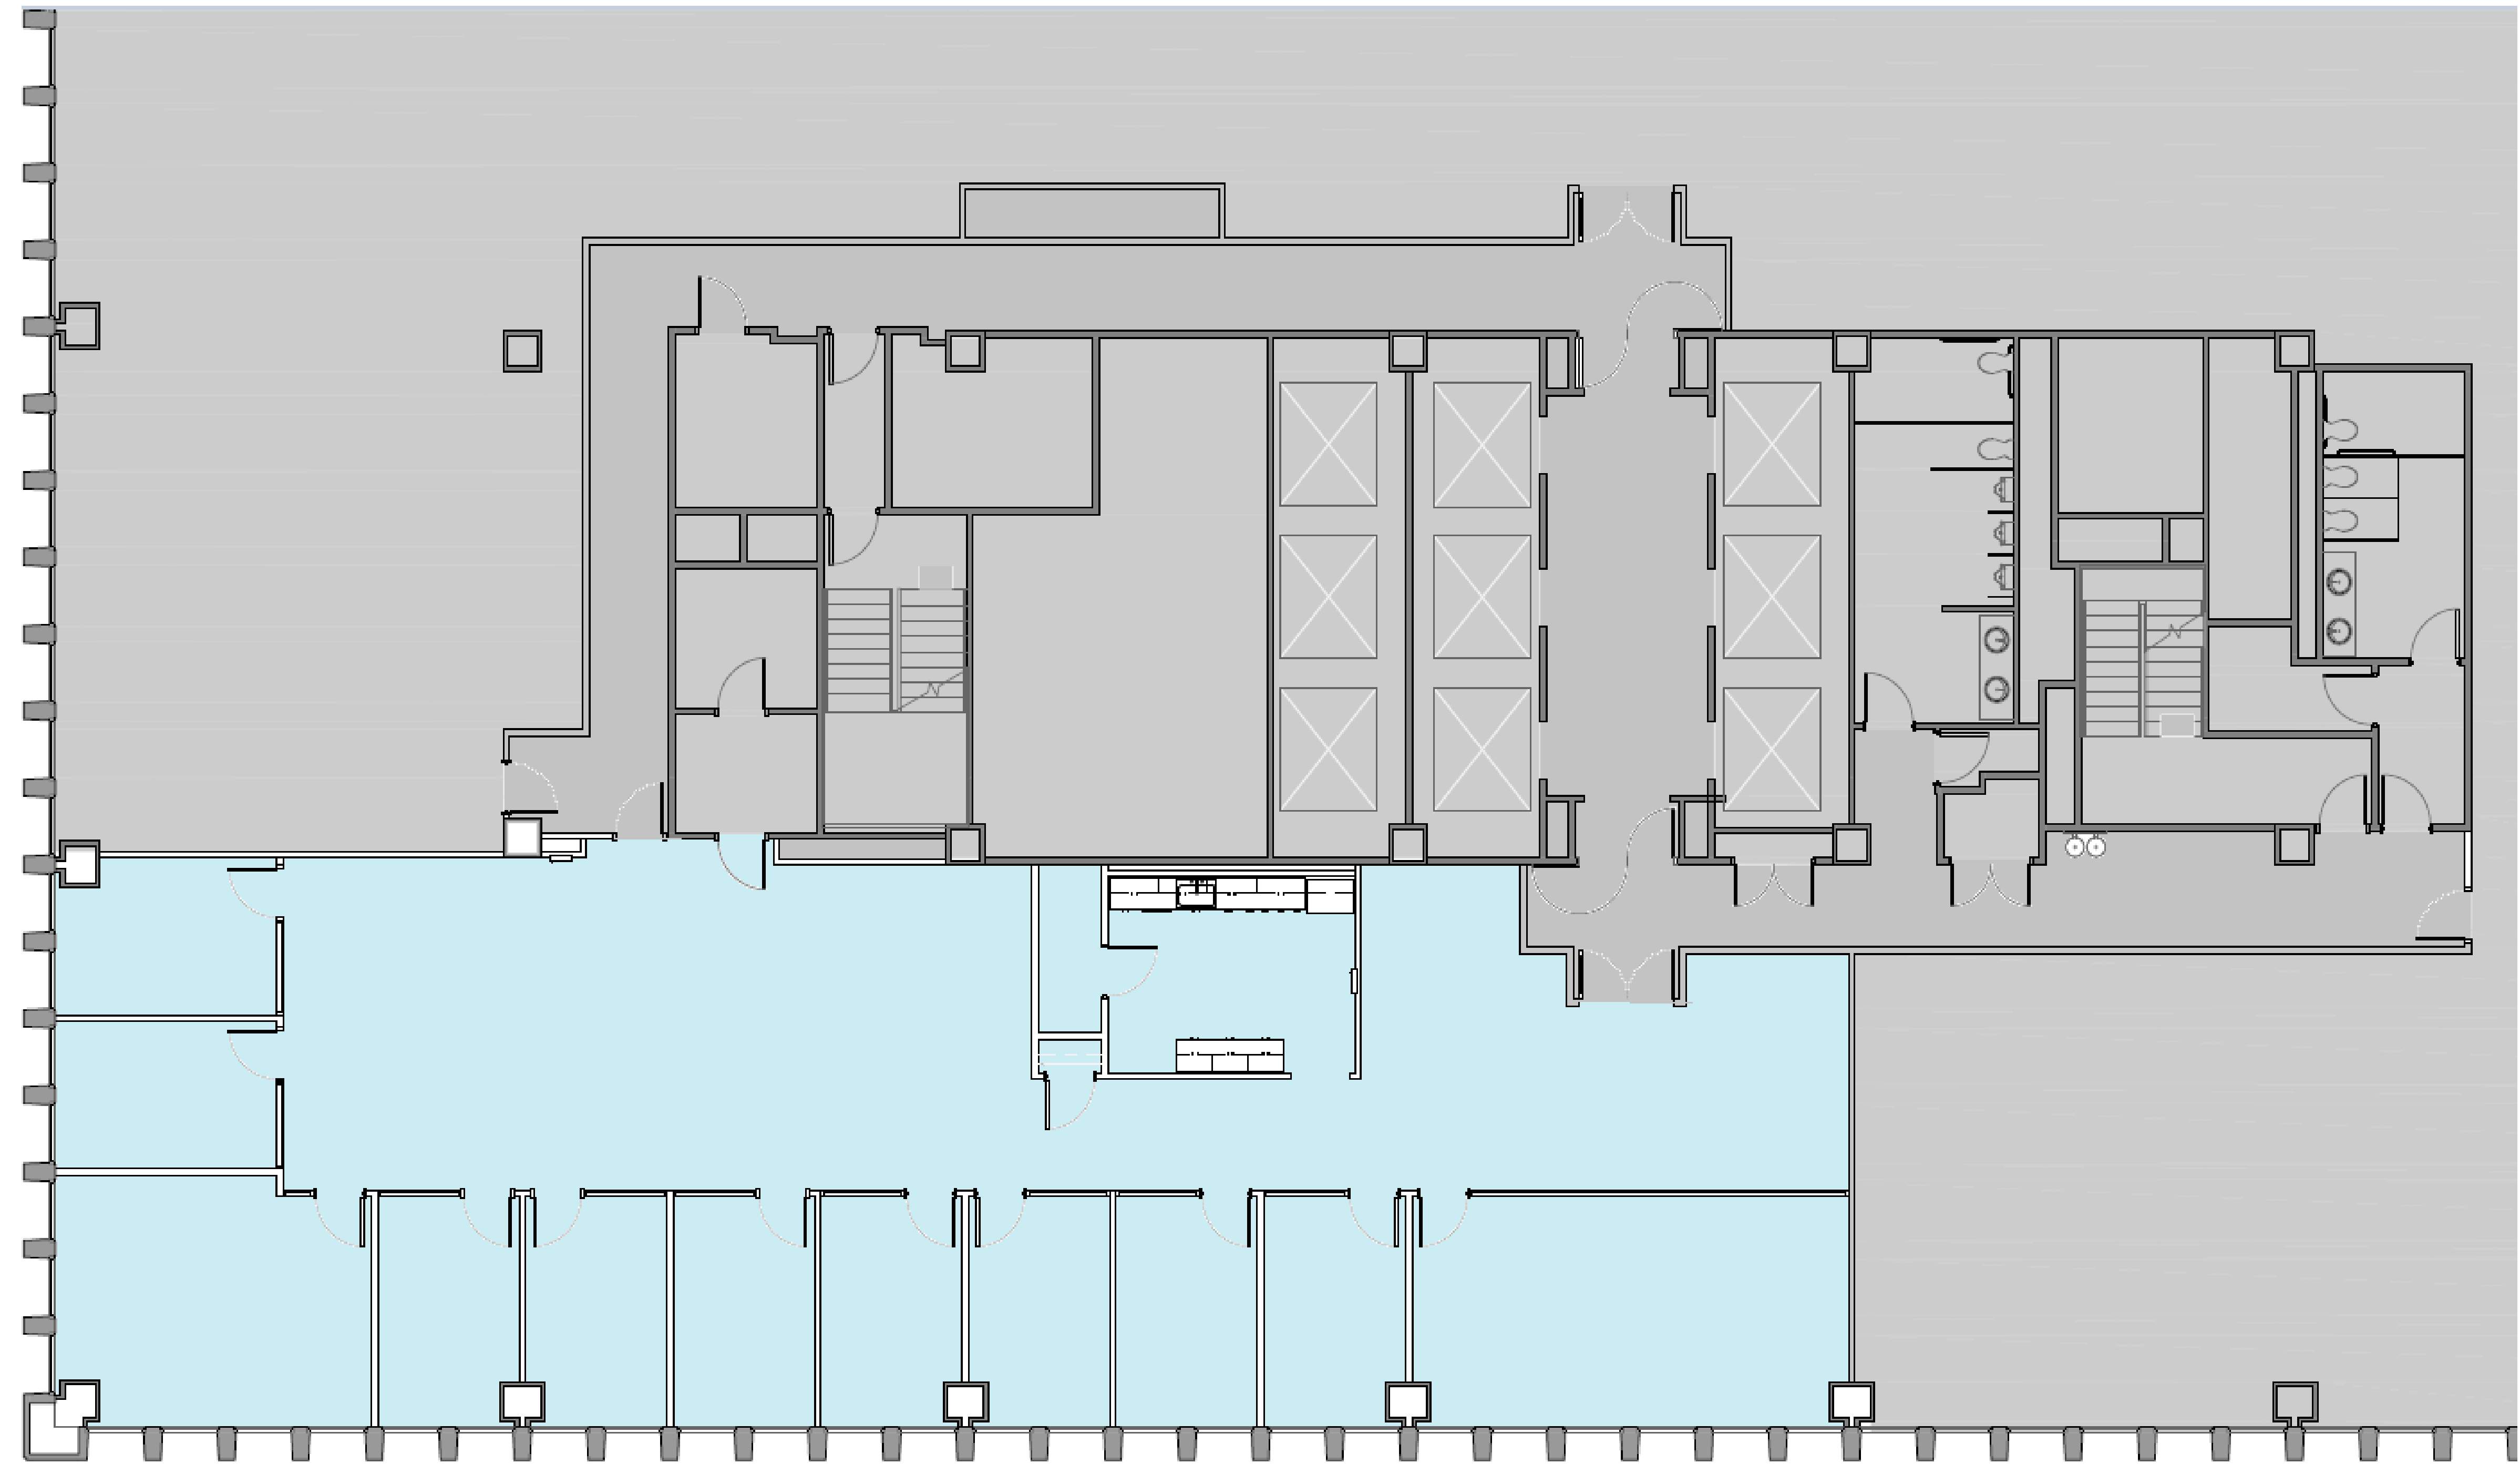

Jim Collins

415.352.7239

[jcollins@shorenstein.com](mailto:jcollins@shorenstein.com)

CA RE 00860991

Tom McDonnell

415.772.7086

[tmcdonnell@shorenstein.com](mailto:tmcdonnell@shorenstein.com)

CA RE 01011145

**NEW on the MARKET!**

GORGEOUS NORTHWESTERN FACING SUITE with DOUBLE  
DOOR ELEVATOR IDENTITY!

10 Window Line Private Offices  
Open area for Work Stations  
Reception Area

1 Conference Room  
Kitchen/Copy Area  
Server Closet



235 Montgomery St,  
San Francisco, CA 94104

