


Elmhurst Metro Court - Bldg. "F"

747 Church Road
Elmhurst, Illinois 60126

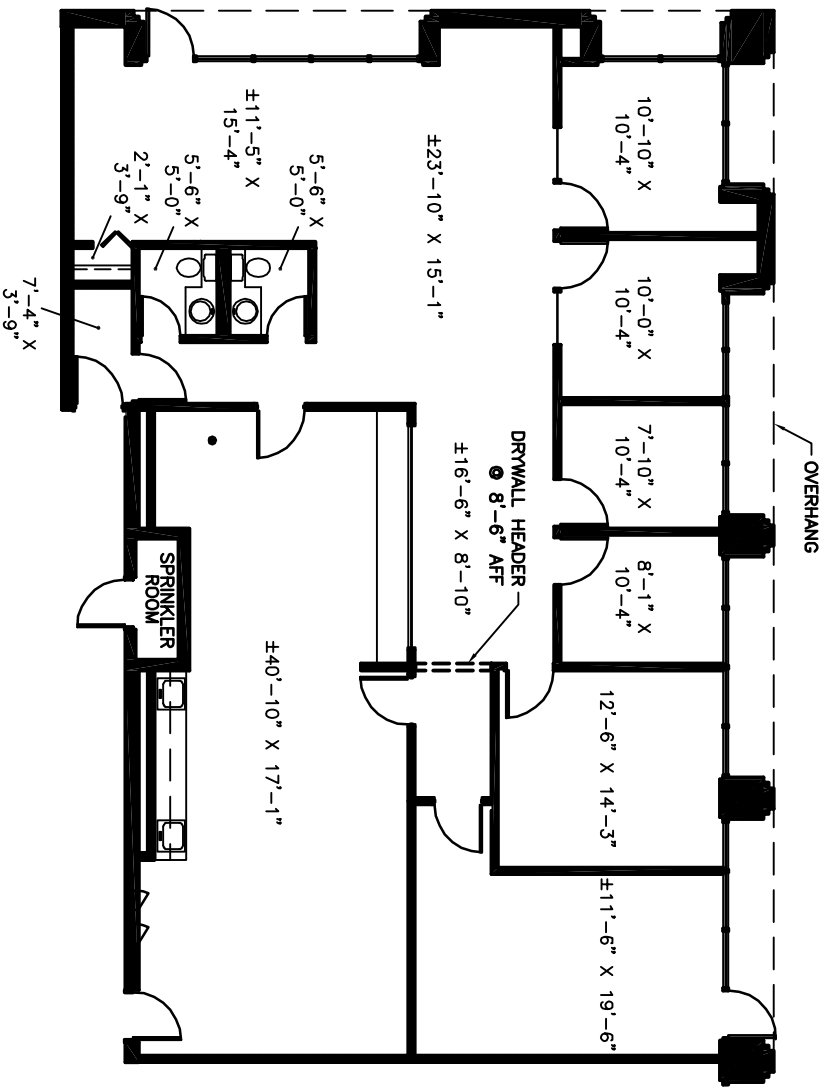

Suite F4-F5 - "As-Built" Conditions

3,049 Rentable Square Feet
0474712.EMC

Scale: N.T.S.

