


Elmhurst Metro Court - Bldg. "E"

747 Church Road
Elmhurst, Illinois 60126

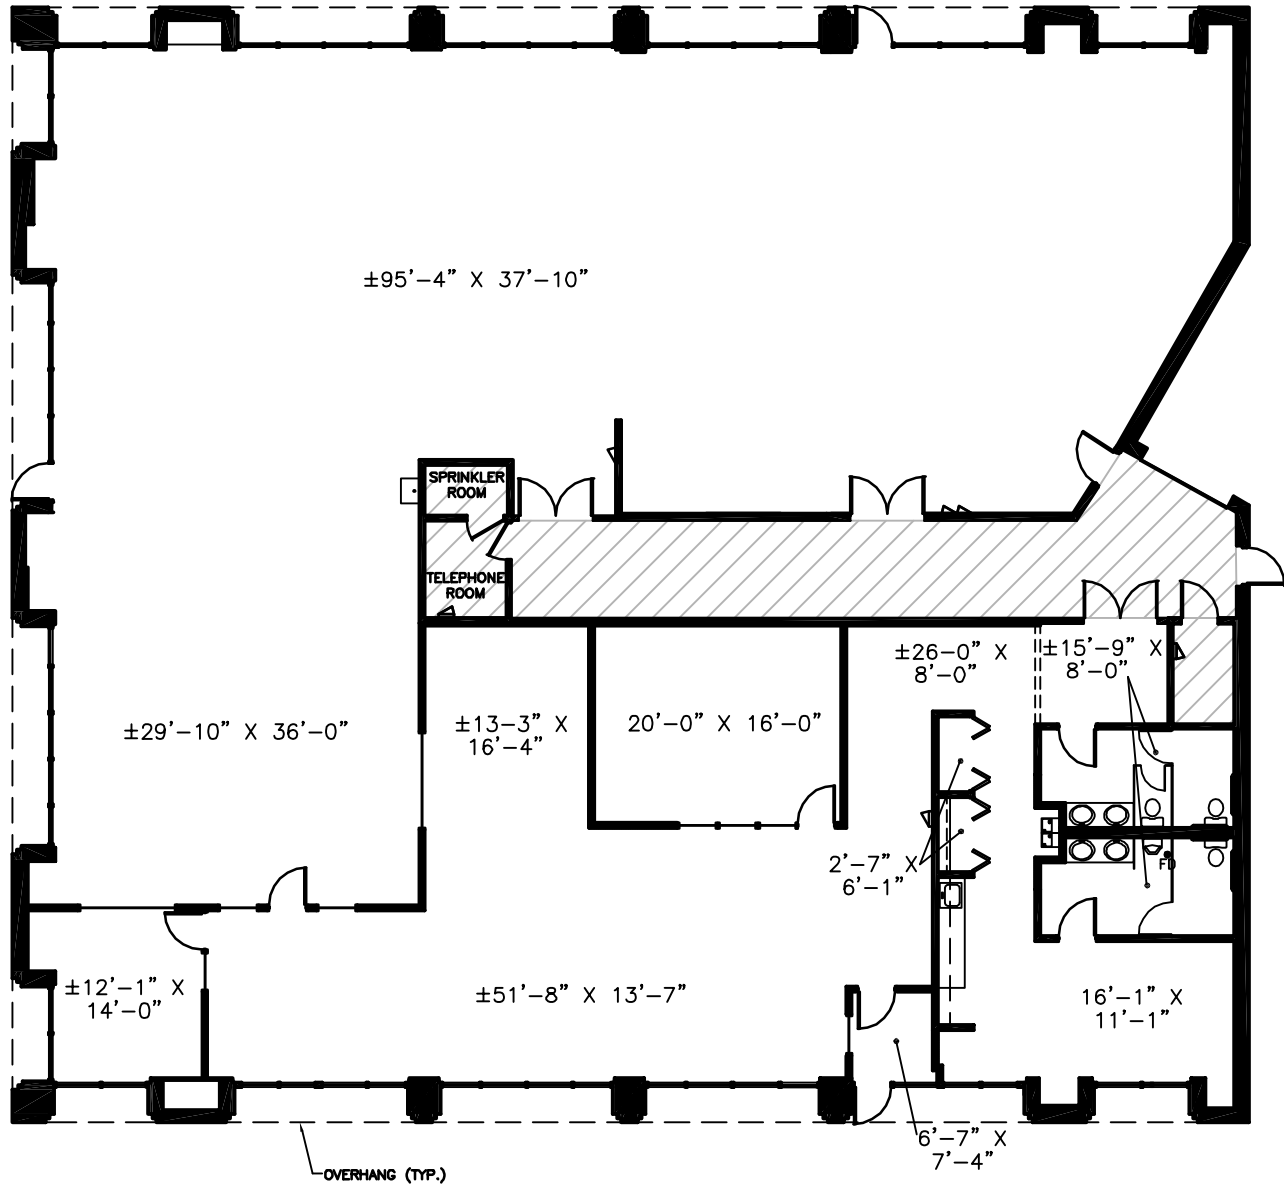

Suite #E1-6 - "As-Built" Conditions

9,000 Rentable Square Feet
0674711.EMC

Scale: N.T.S.

