
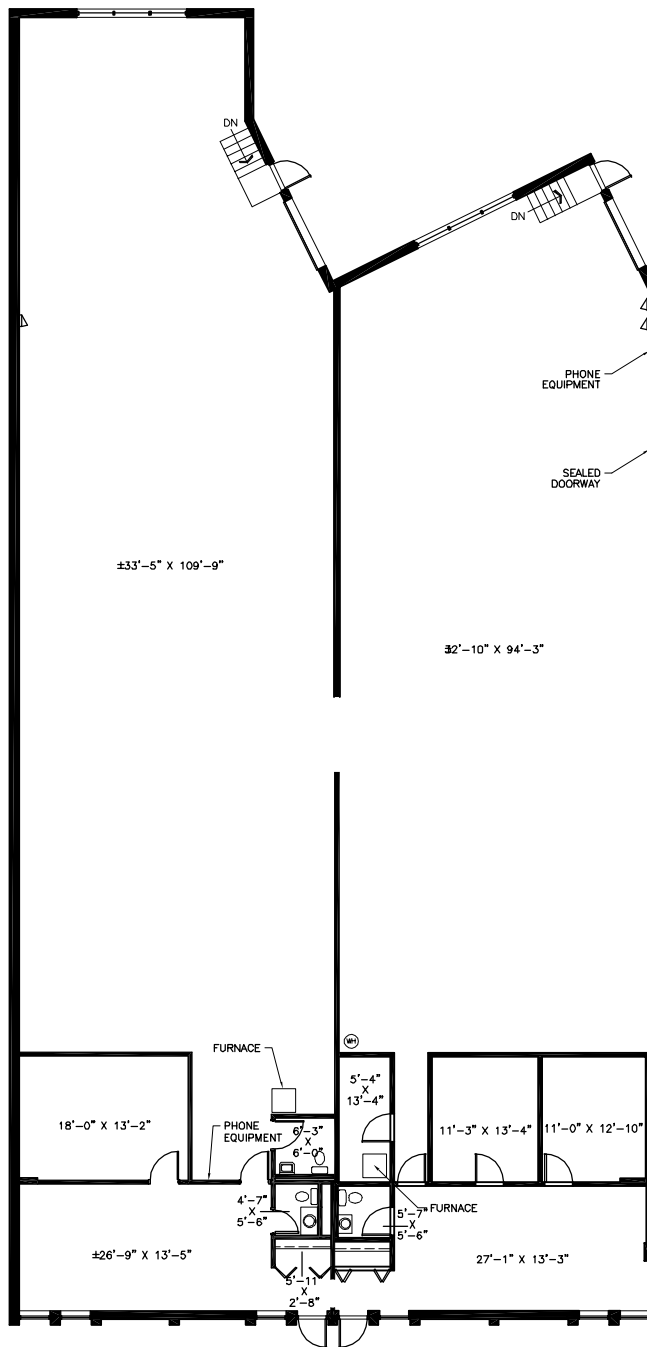


Willowbrook Court

681-683 Executive Drive
Willowbrook, Illinois 60521

KEY PLAN: 

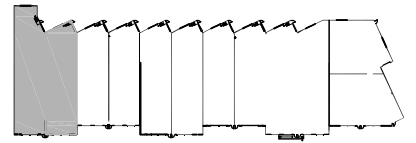

Suite #681-#683 - As-Built Conditions

#681 - 4,624 Rentable Square Feet
#683 - 3,980 Rentable Square Feet
Total Rentable Square Feet - 8,604

Scale:

N.T.S.

