


Elmhurst Metro Court - Bldg. "A"

747 Church Road
Elmhurst, Illinois 60126

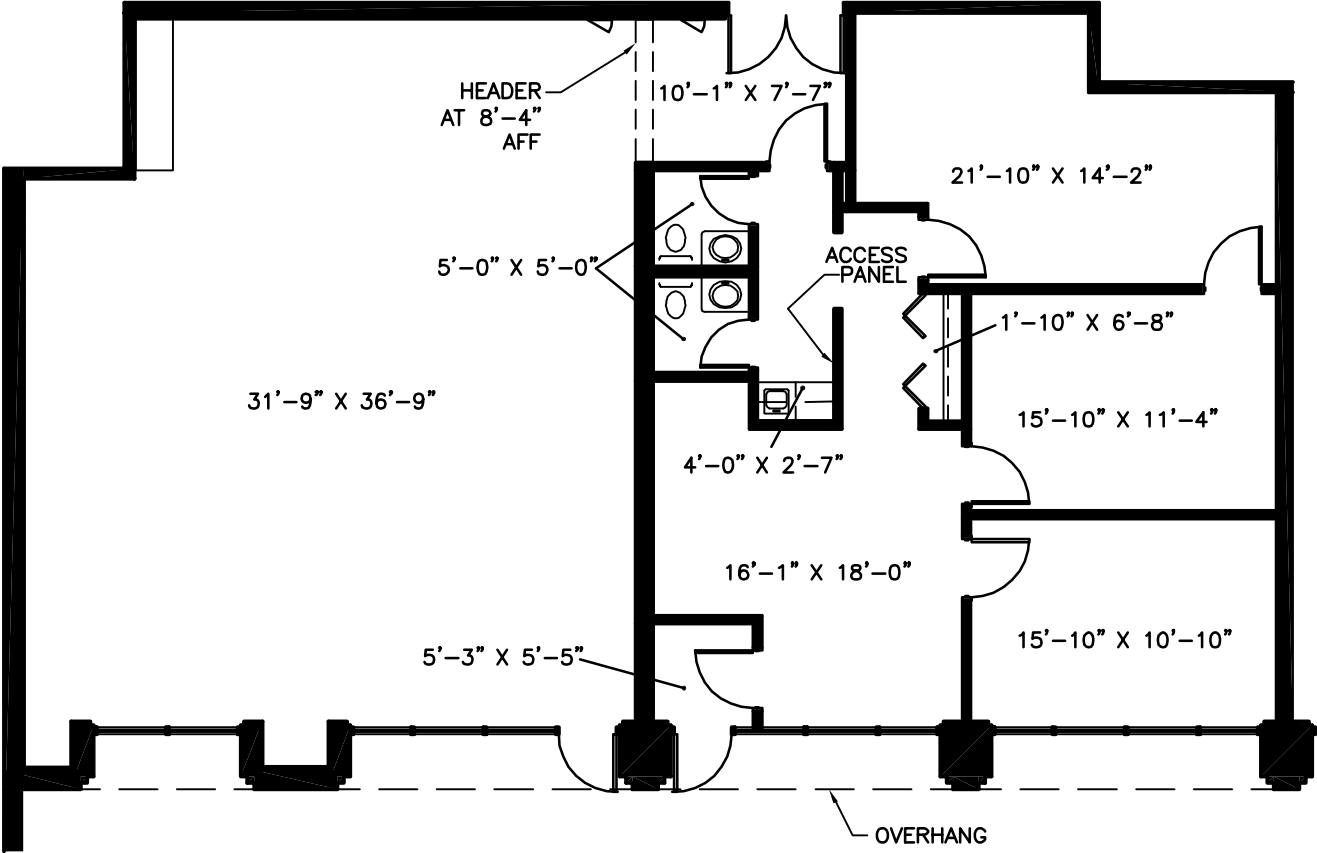

Suite # A-1-A-2 "As-Built"

2,966 Rentable Square Feet
1074713.EMC

Scale: N.T.S.

