


# Elmhurst Metro Court - Bldg. "F"

747 Church Road  
Elmhurst, Illinois 60126

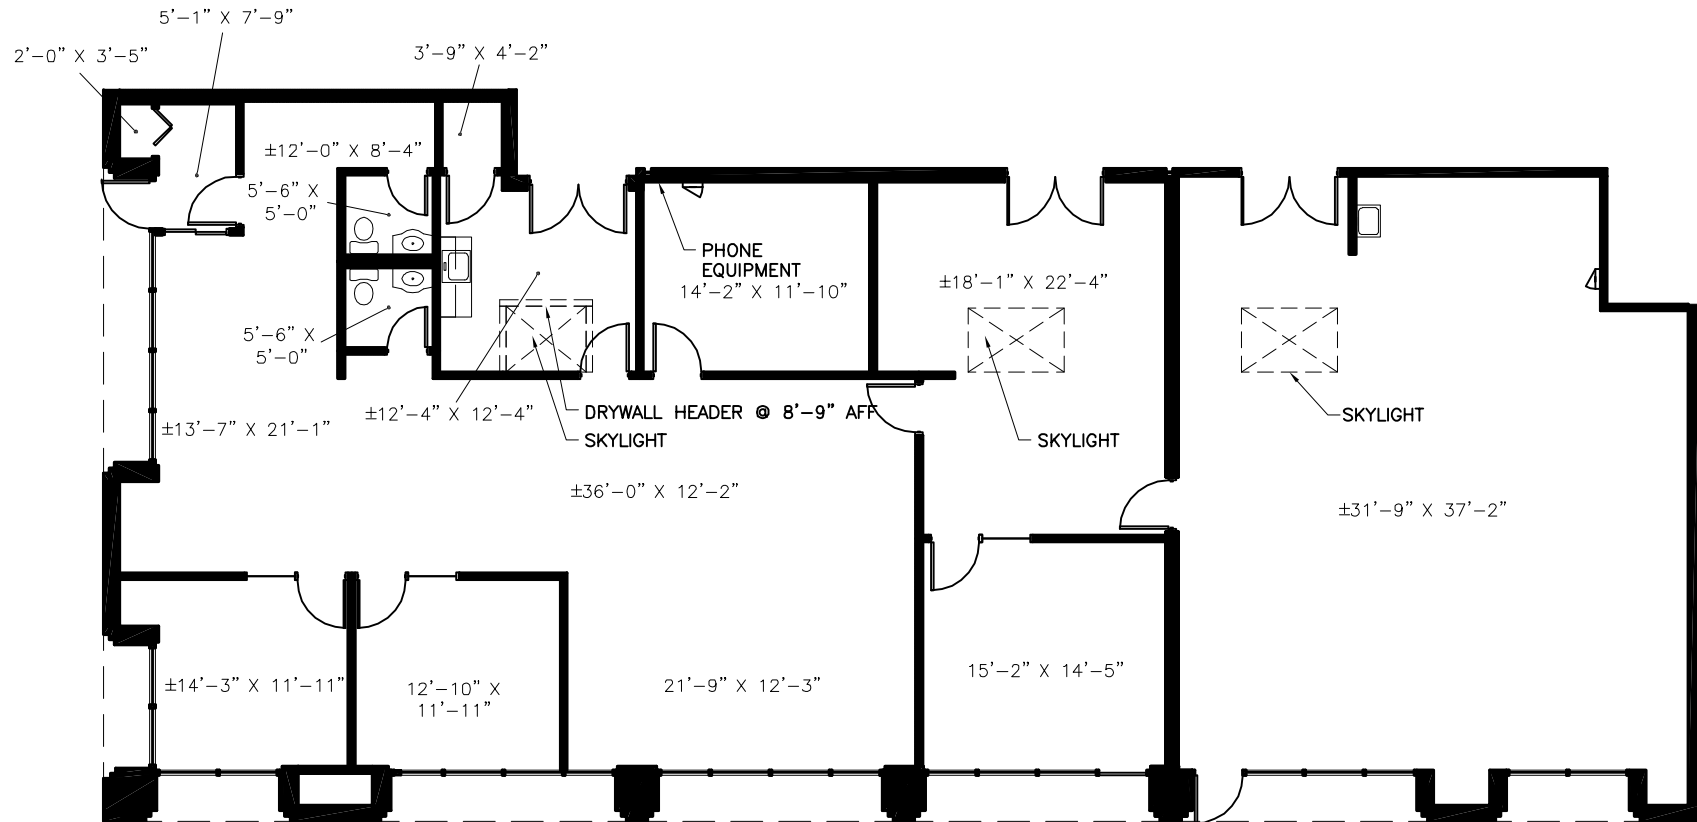

## Suite #F1/F2/F3 - As-Built Conditions

4,560 Rentable Square Feet  
1174717.EMC

Scale:

N.T.S.



DENHOLTZ  
ASSOCIATES

