


KEY PLAN

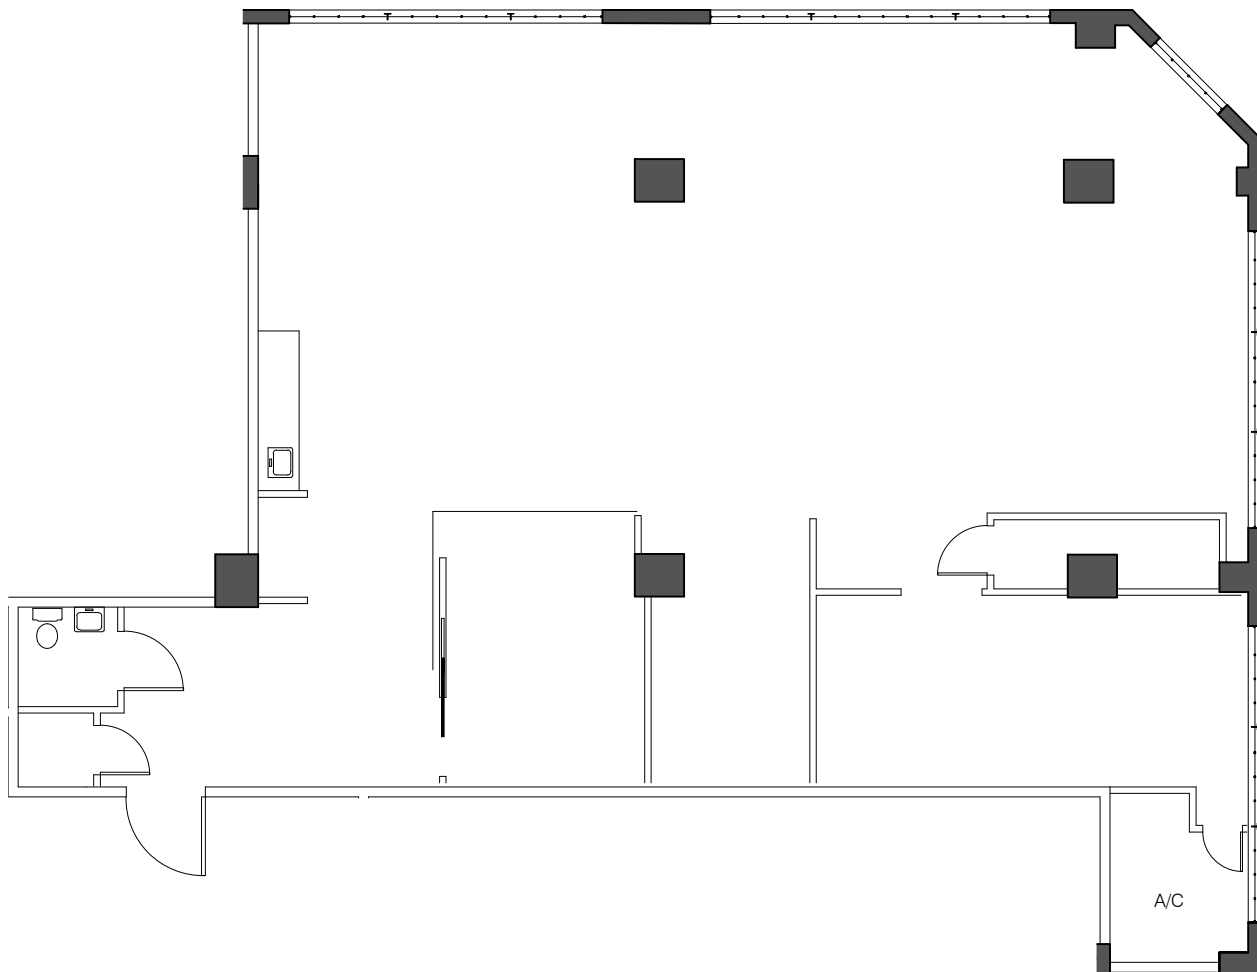

SCALE: N.T.S.

SUITE M223 EXISTING CONDITIONS PLAN

FLOOR 2M
601 WEST 26th STREET
NEW YORK, NY

PROJECT LOCATION: S:\Construction\Renovation\601 W 26th Street\Regional\AsBuilt\601	
FILE NAME: 601_26st_m223.dwg	PLOT DATE: Mar 16, 2021 - 3:54pm
DATE: Mar 16, 21	DRAWING NO.:
DRAWN BY: jrodriguez	DS-1

