


12TH FLOOR  
FULL FLOOR  
AS BUILT

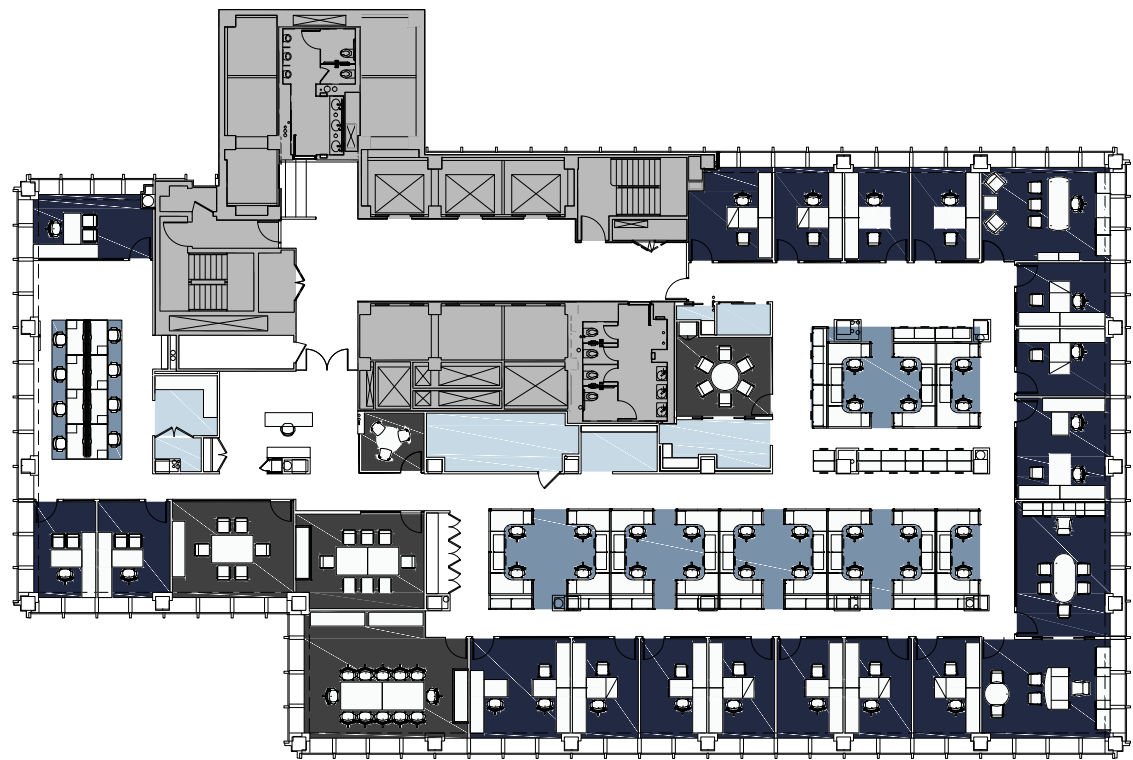

16,310 RSF	
Private Offices	16
Executive Office	4
Conference Room	5
Work Stations	32
Pantry	2
Reception	1
<hr/>	
TOTAL	53

