


KEY PLAN



SCALE 1/16" = 1'-0"

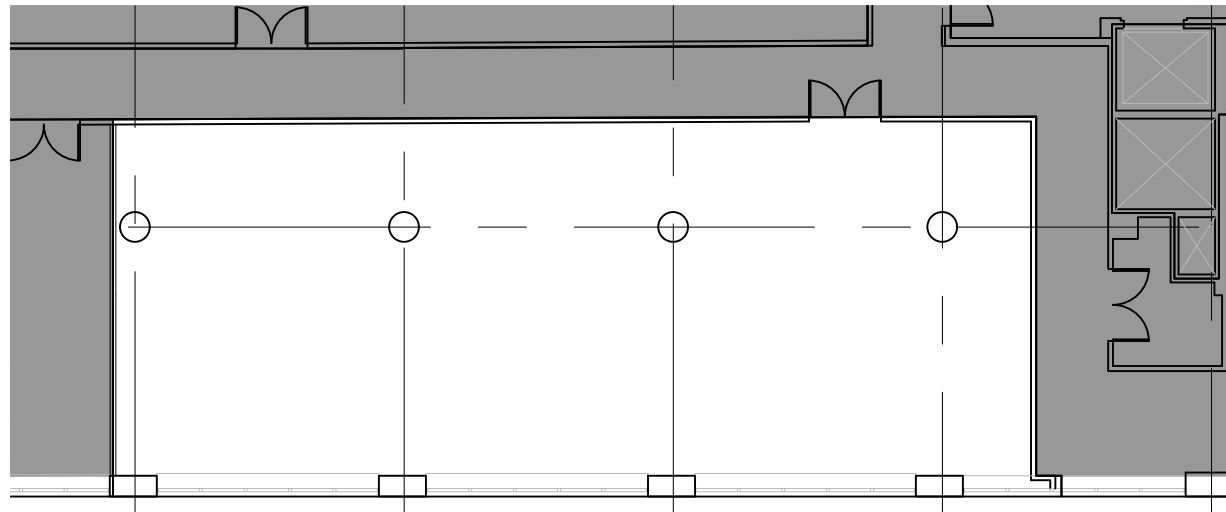

**AS-BUILT**  
EXISTING CONDITIONS

SUITE107  
37-18 NORTHERN BLVD  
LIC, NEW YORK

S:\Construction\Manhattan\37-18 SMP Building\Regional\AsBuilts\2022\asb-1	
FILE NAME	37-18 Northern Boulevard - SMP Building-Floor 1-AS BUILT PLAN.dwg
DATE	Jun 30, 22
DRAWN BY	sching
PLOT DATE	
DRAWING NO.	EX-1