


KEY PLAN



SCALE 3/32" = 1'-0"

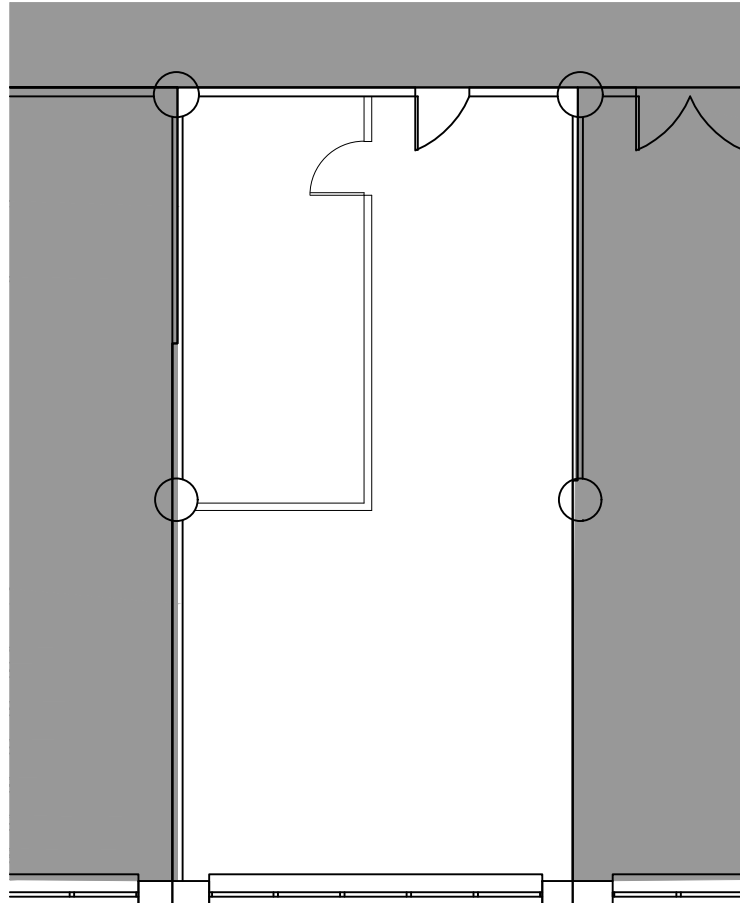

AS-BUILT
EXISTING CONDITIONS

SUITE 304
37-18 NORTHERN BLVD
LIC, NEW YORK

S:\Construction\Manhattan\37-18 SMP Building\Regional\AsBuilts\2022\asb-1	
FILE NAME	PLOT DATE
37-18 Northern Boulevard - SMP Building-Floor 3-AS BUILT PLAN.dwg	
DATE	Jun 30, 22
DRAWN BY	sching
DRAWING NO.	
EX-1	