


KEY PLAN

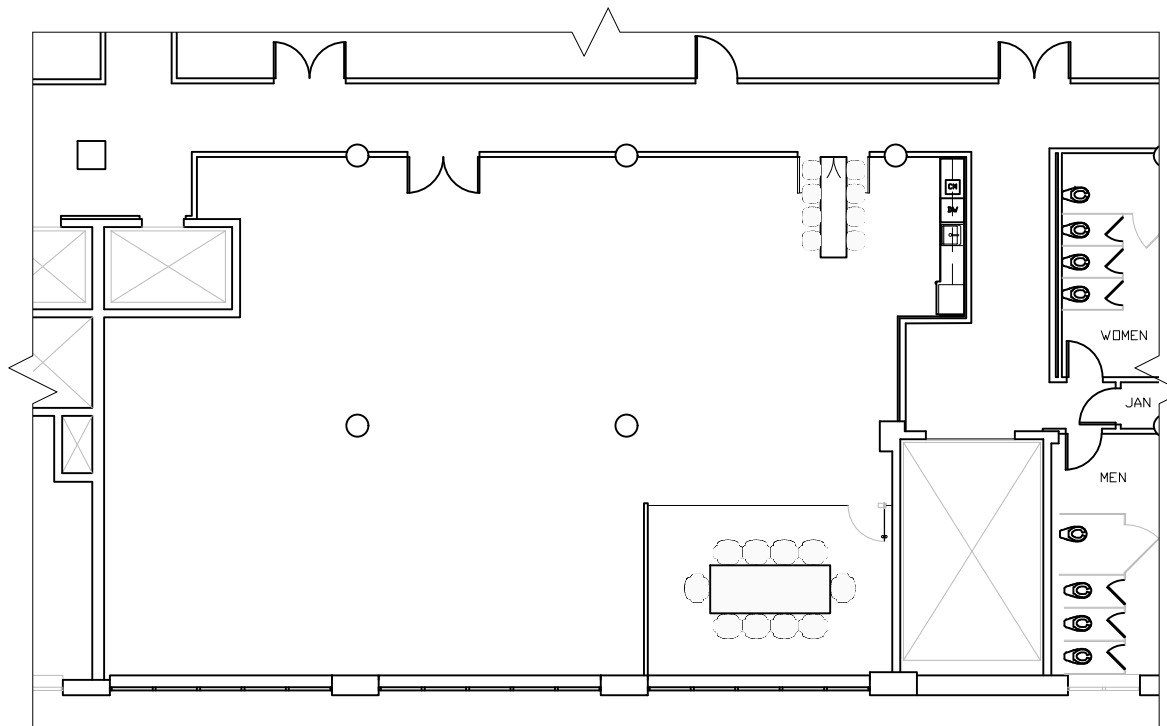

AS-BUILT
EXISTING CONDITIONS

SUITE 413-417
37-18 NORTHERN BLVD
LIC, NEW YORK

B:\Construction\Manhattan\21-18 SHP Building\Regional\AsBuilt\		
FILE NAME SHP_413_417.dwg		PLOT DATE
DATE	Jun 01, 22	DRAWING NO.
DRAWN BY	abershatky	EX-1