Butterfield Office Plaza

2625 Butterfield Road
Oak Brook, Illinois 60523

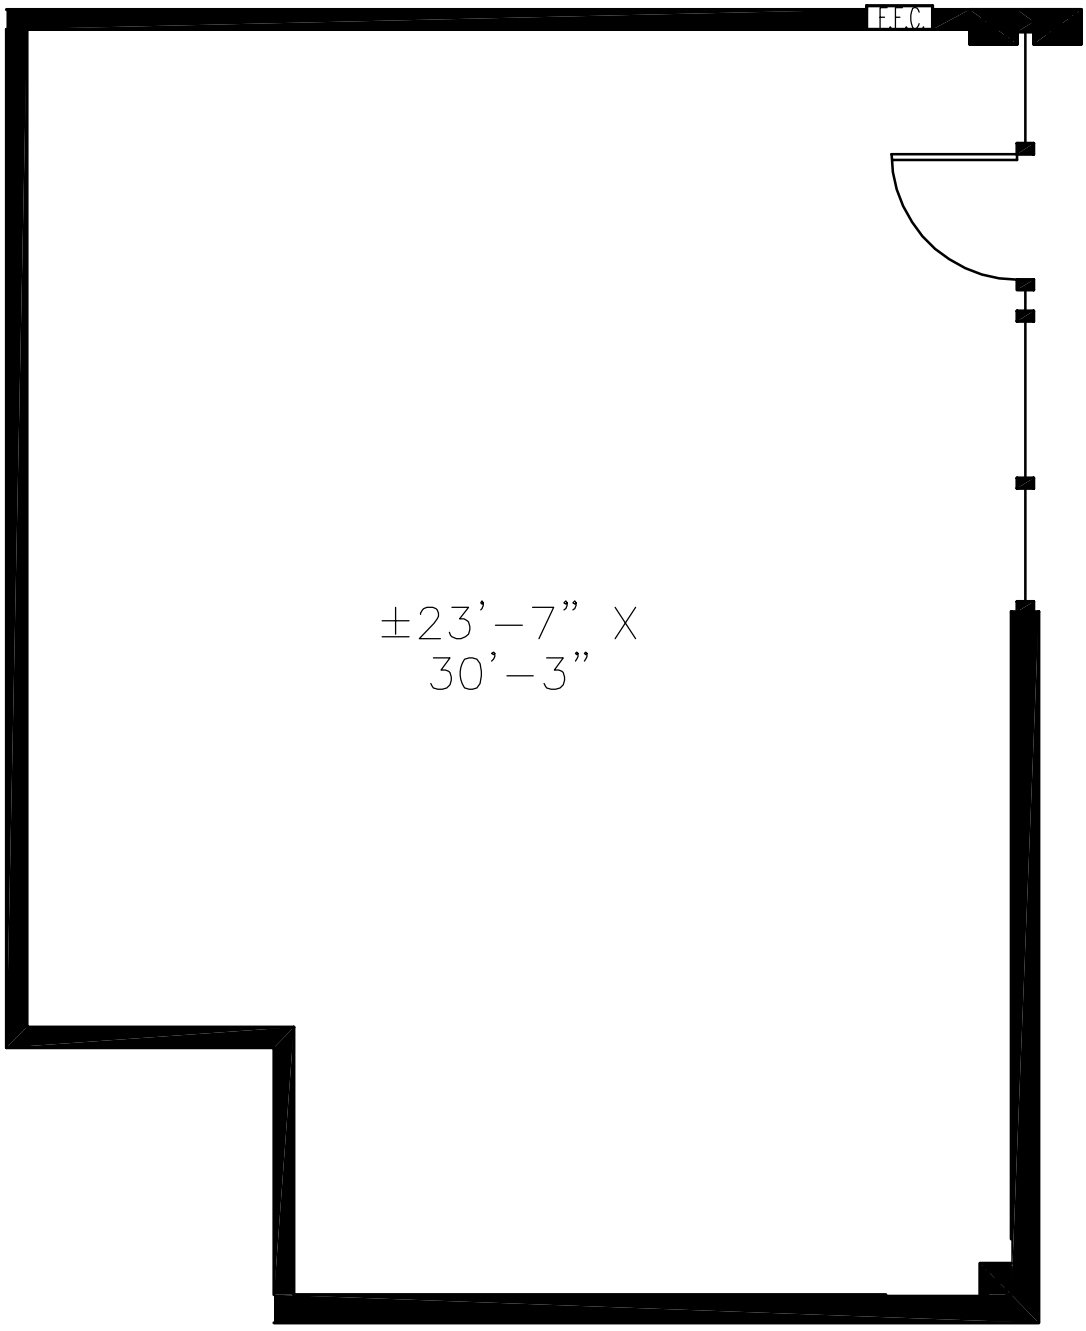

Suite #211S - "As-Built" Conditions

824 Rentable Square Feet
12262502.BOP

Scale: N.T.S.

DENHOLTZ ASSOCIATES

North