AVAILABILITIES — FLOOR PLAN

2275 UPPER MIDDLE ROAD - SUITE 201
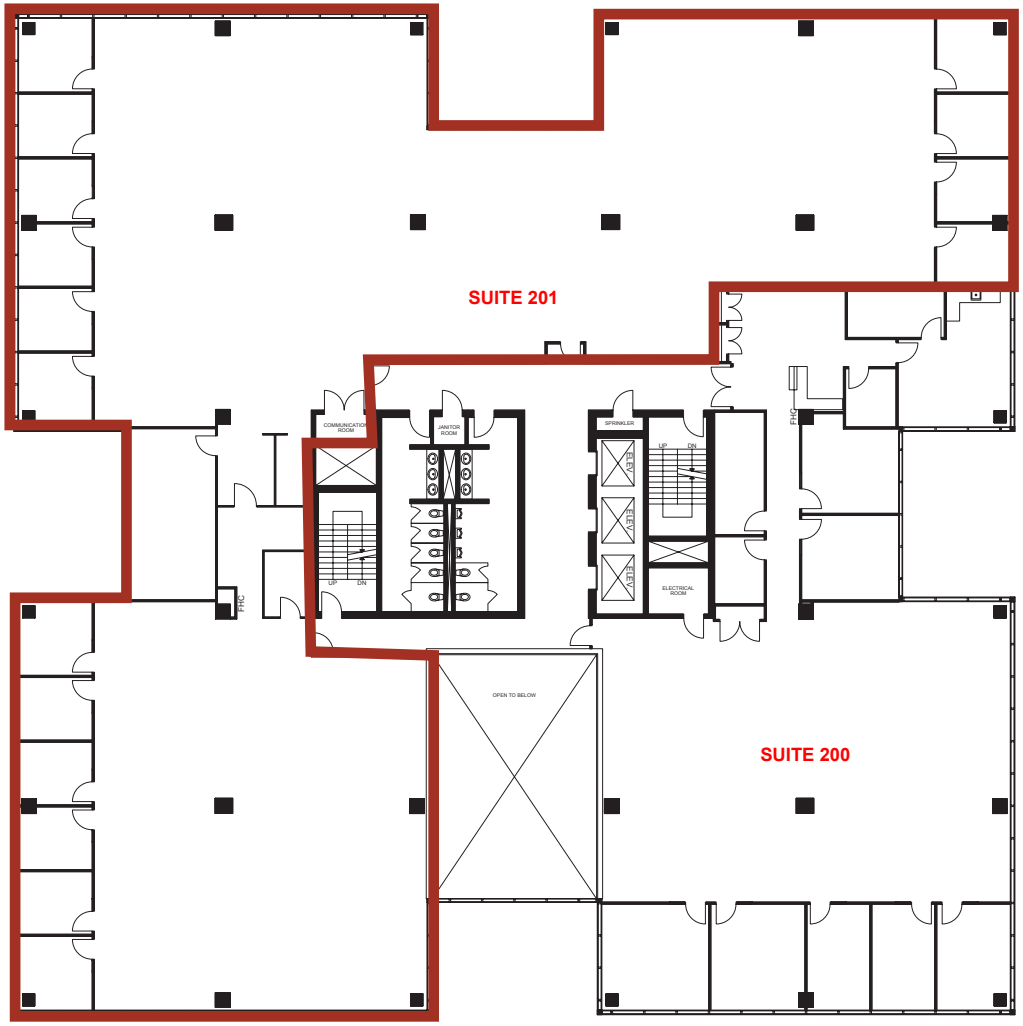
(AS BUILT DRAWING)